
**EMPTING & FILLING VALVES**

(shown for river wall emptying valve -
 LWEV wire prefix 3E
 LWFV wire prefix 4F
 RWFV wire prefix 2F)

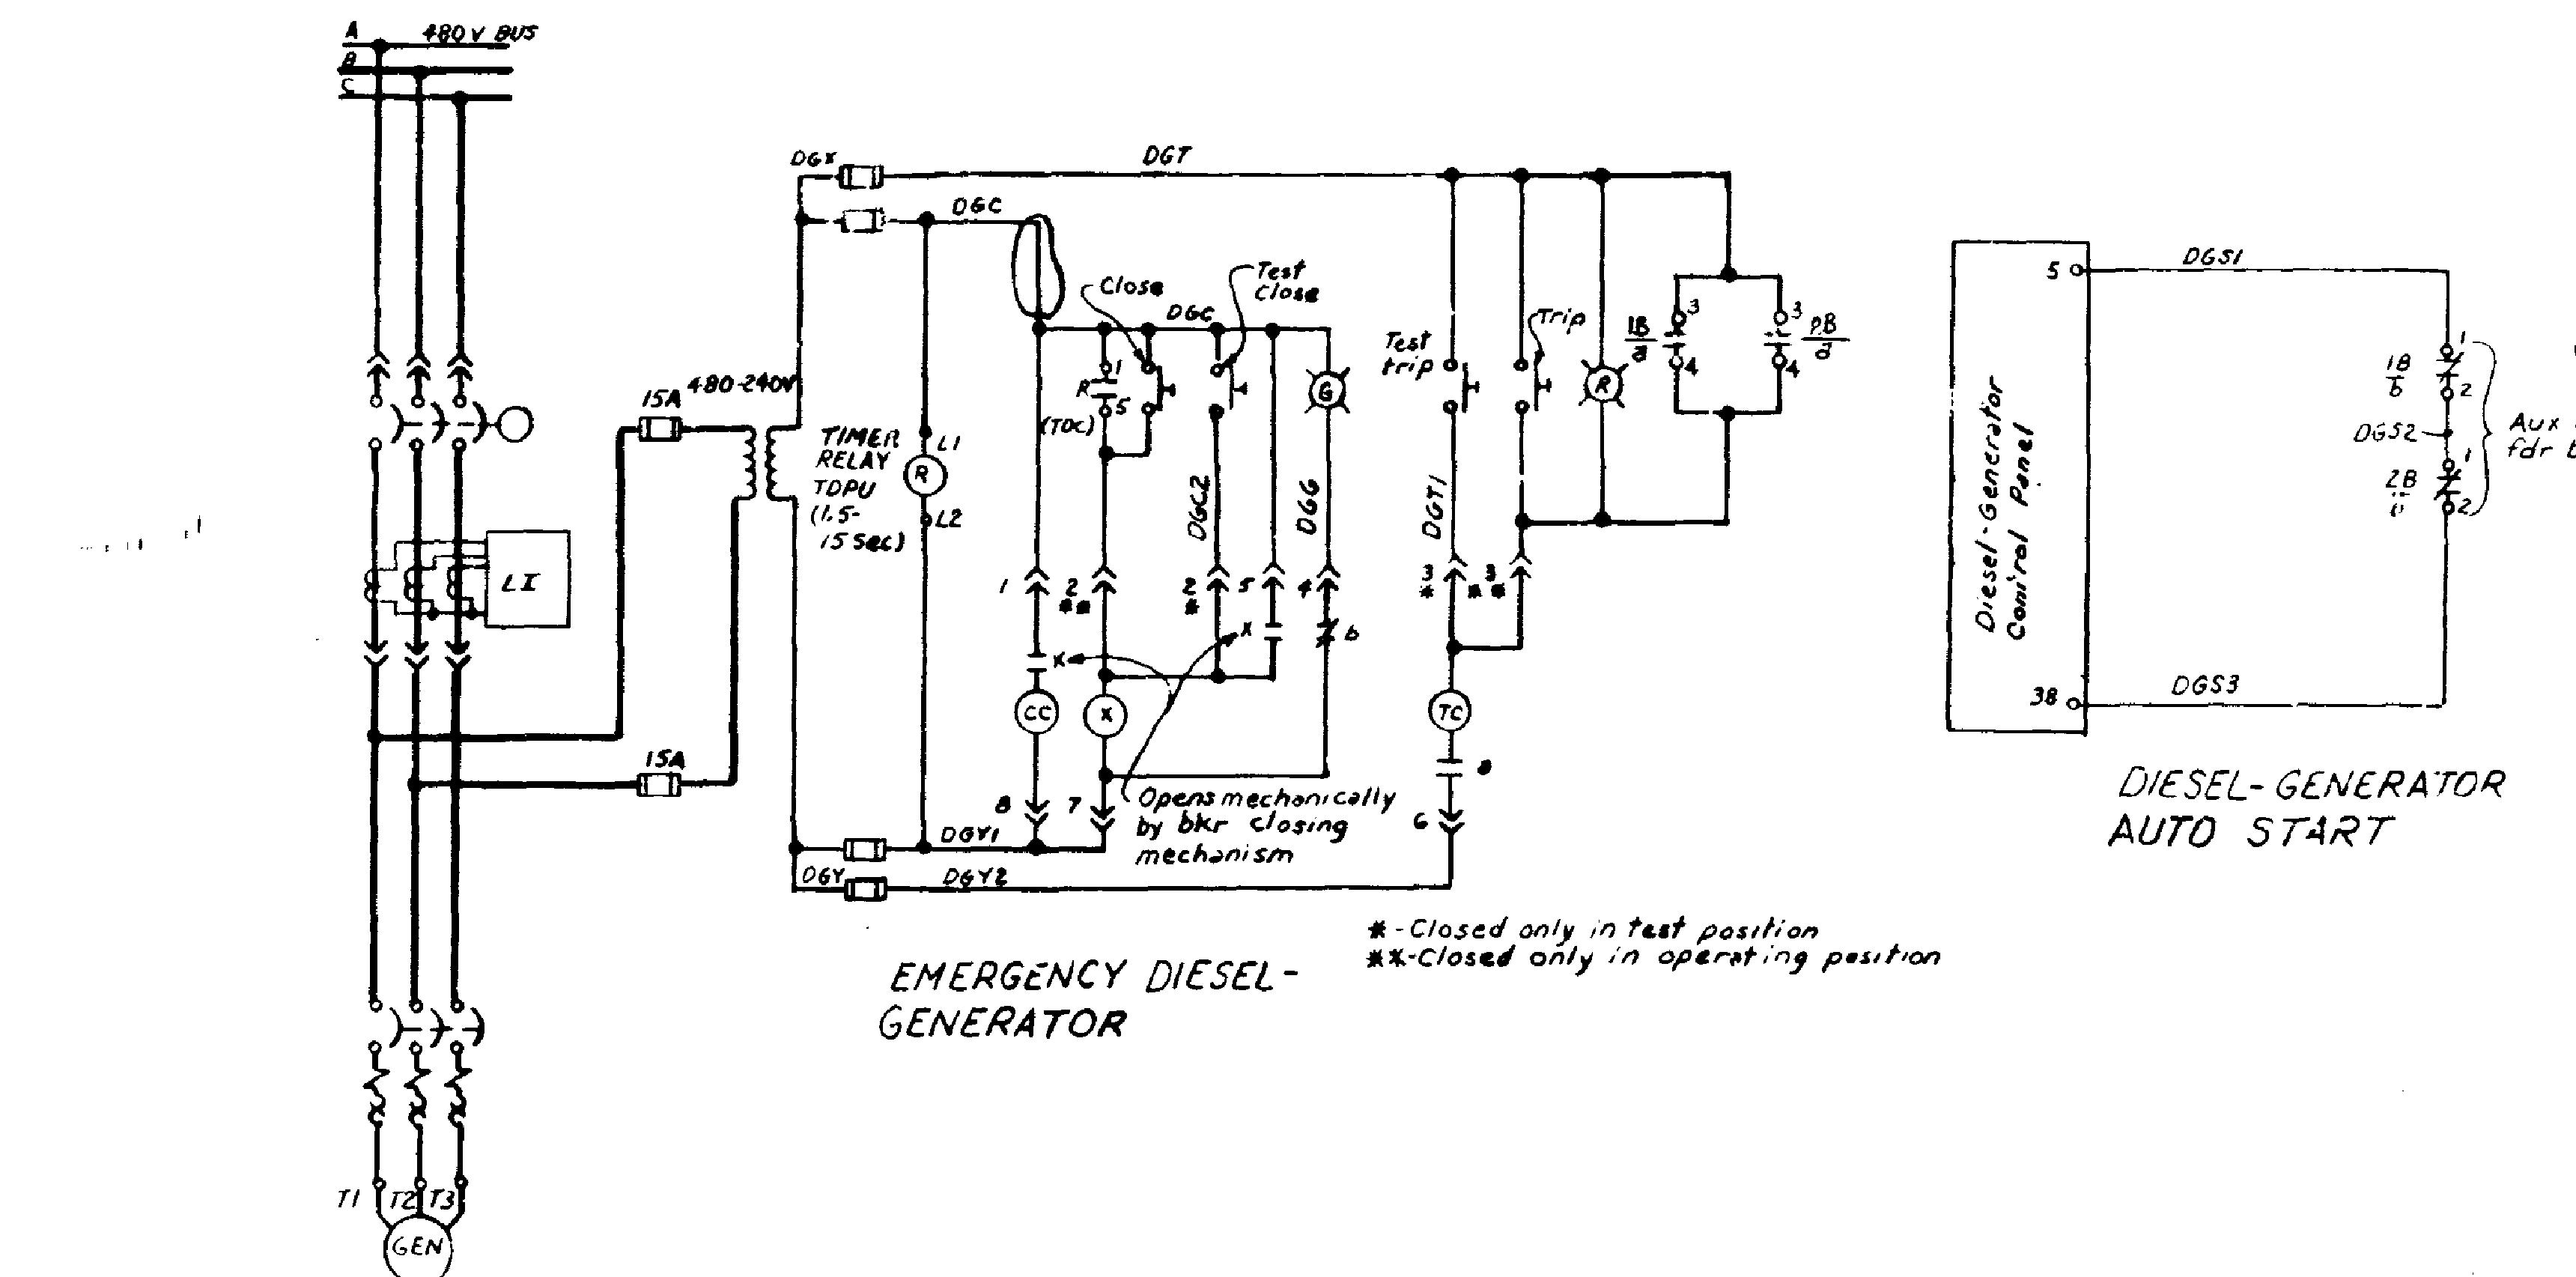

1	2	3	100
1	2	3	100
1-19-90 — MB MON 28185		
3	FIELD CHANGE AS CONSTRUCTED MEMO LOC TO JRF DATED 11/14/89 (CO4891114503)	
2	14000 D.C. DIESEL GENERATOR	
REV NO	ECN/CR	DATE
AUXILIARY LOCK		
WIRING DIAGRAMS 480 V A-C POWER SCHEMATIC DIAGRAMS SH-1		
NICKAJACK PROJECT TENNESSEE VALLEY AUTHORITY DIVISION OF ENGINEERING DESIGN		
SUBMITTED	RECOMMENDED	APPROVED
2000-10-10	Re: C. I. C. K. M. C. C. C. C. C. C.	2000-10-10
KNOXVILLE 3-6-87 69 E 65N1728 R3		
RECORD DRAWING AS CONSTRUCTED		