
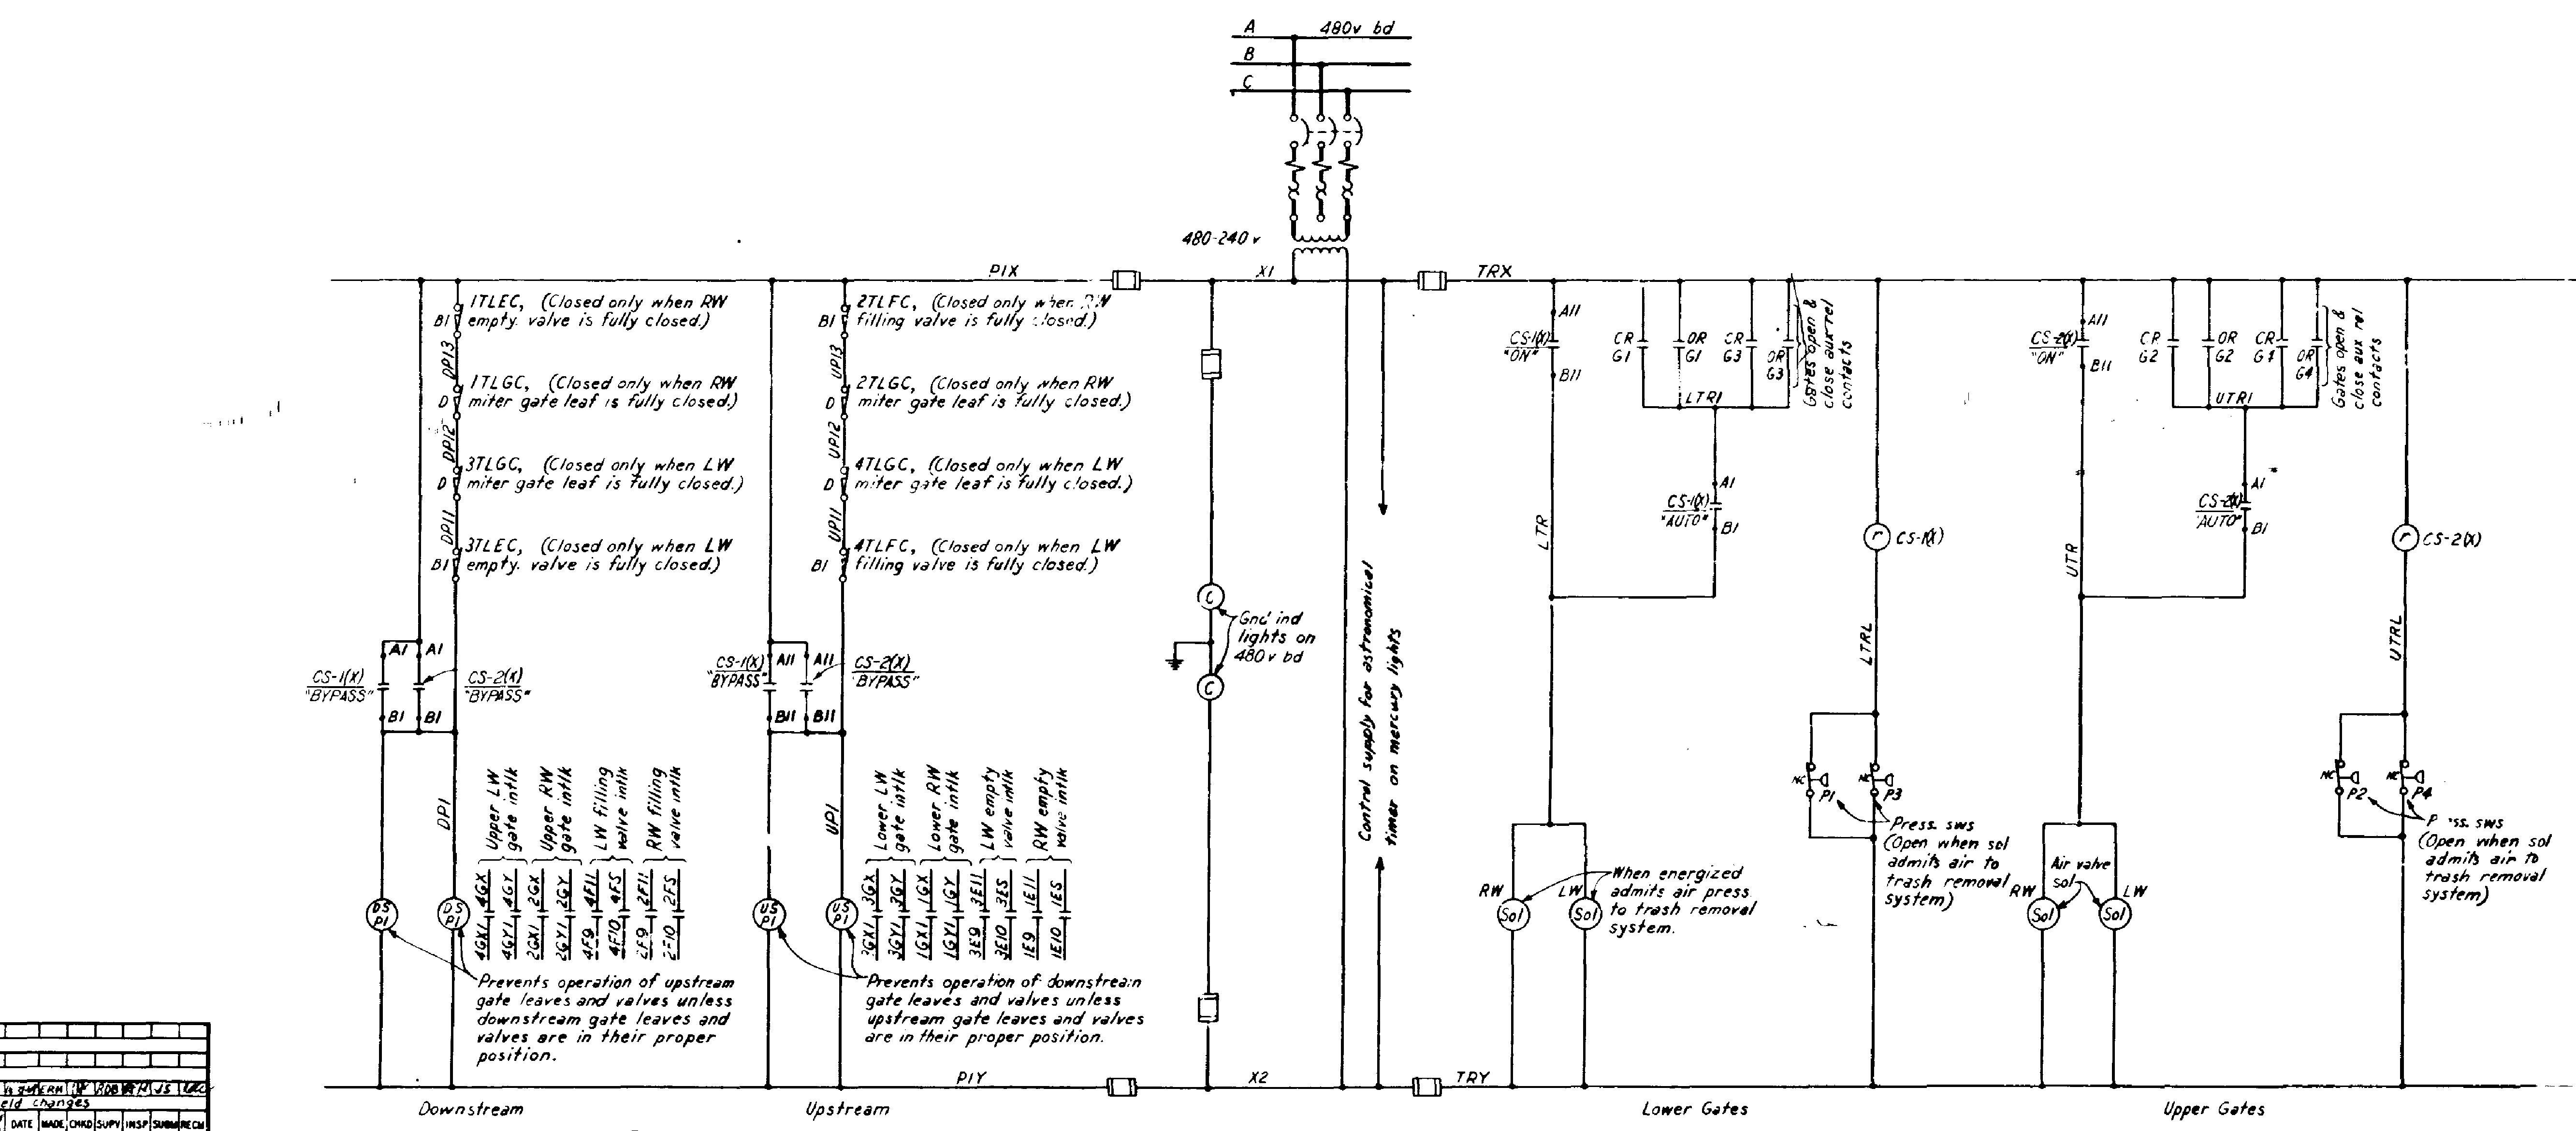


65N1729

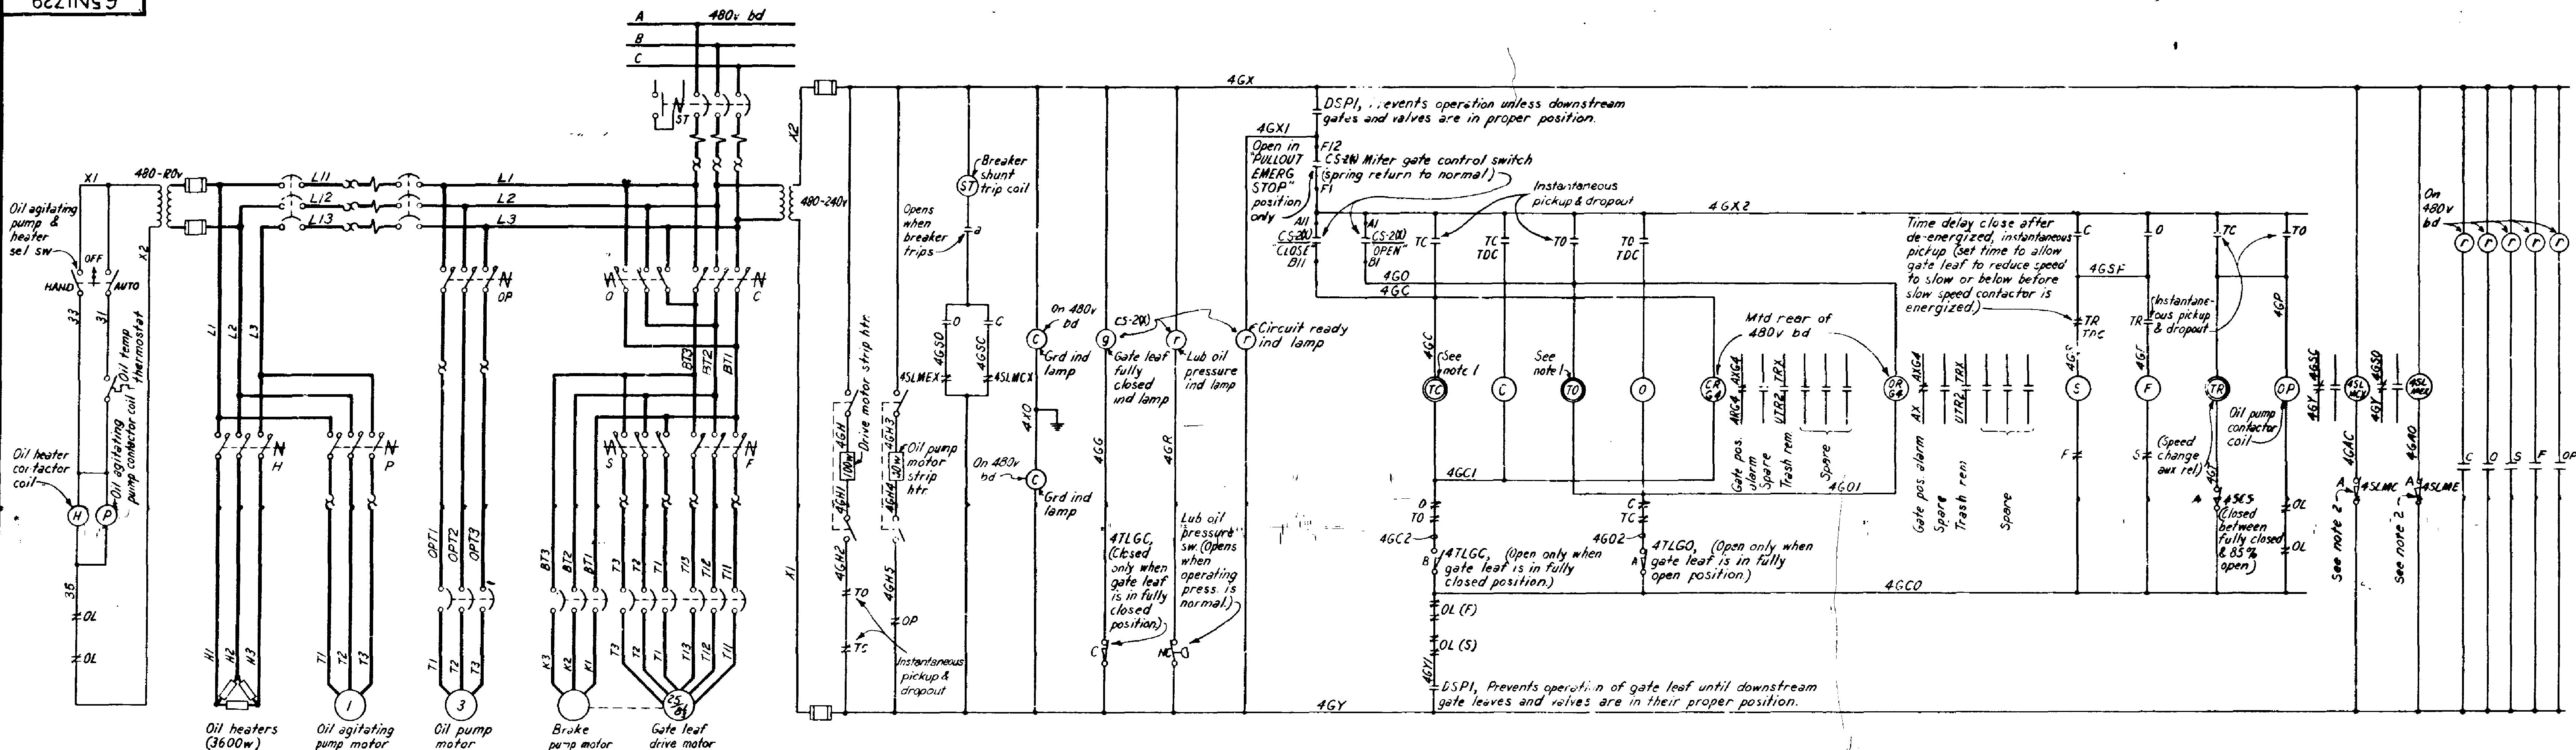

Field Changes	
REV DATE	NAME CHG SUPPLY HIPS SUBMISSION
0208	SUPP. 4TP
DRW NO.	HIPS
CHG. 007	CHG. 007
TRD. 007	TRD. 007
CCL. 007	CCL. 007

AUXILIARY LOCK		
WIRING DIAGRAMS 480V A-C POWER		
SCHEMATIC DIAGRAMS SH-2		
NICKAJACK PROJECT TENNESSEE VALLEY AUTHORITY DIVISION OF DESIGN		
SUBMITTED	RECOMMENDED	APPROVED
K. J. Campbell	K. J. Campbell	K. J. Campbell
KNOXVILLE 3-6-67 69 E 4 65N1729 RI		
RECORD DRAWING AS CONSTRUCTED		