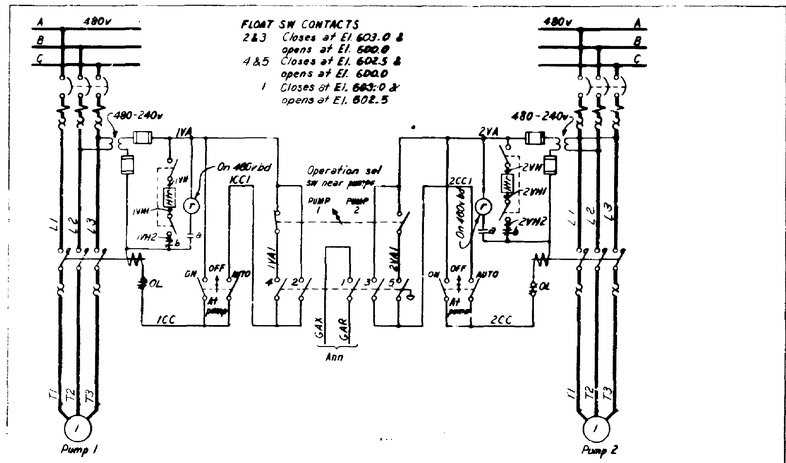

CABLE GALLERY SUMP PUMPS

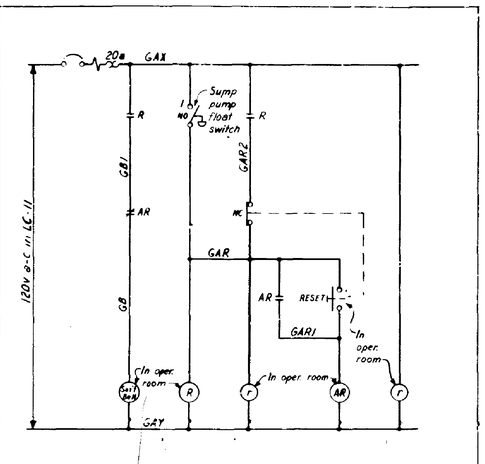

CABLE GALLERY HIGH WATER ALARM

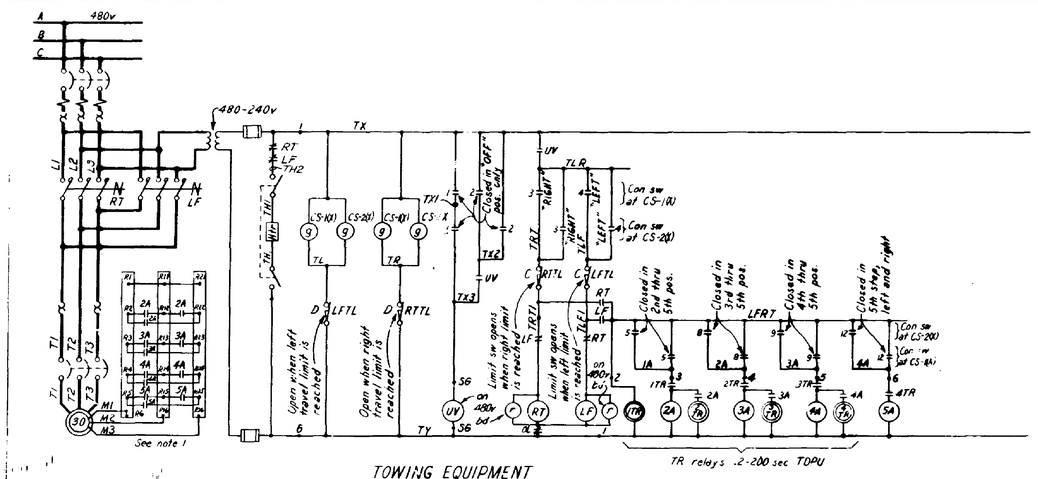

TOWING EQUIPMENT

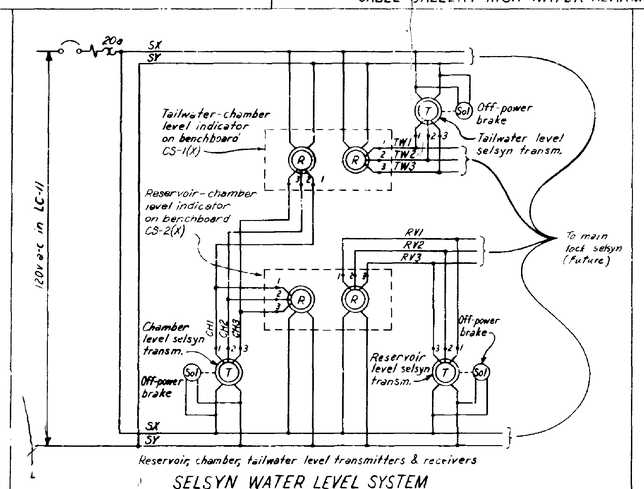

SELSYN WATER LEVEL SYSTEM

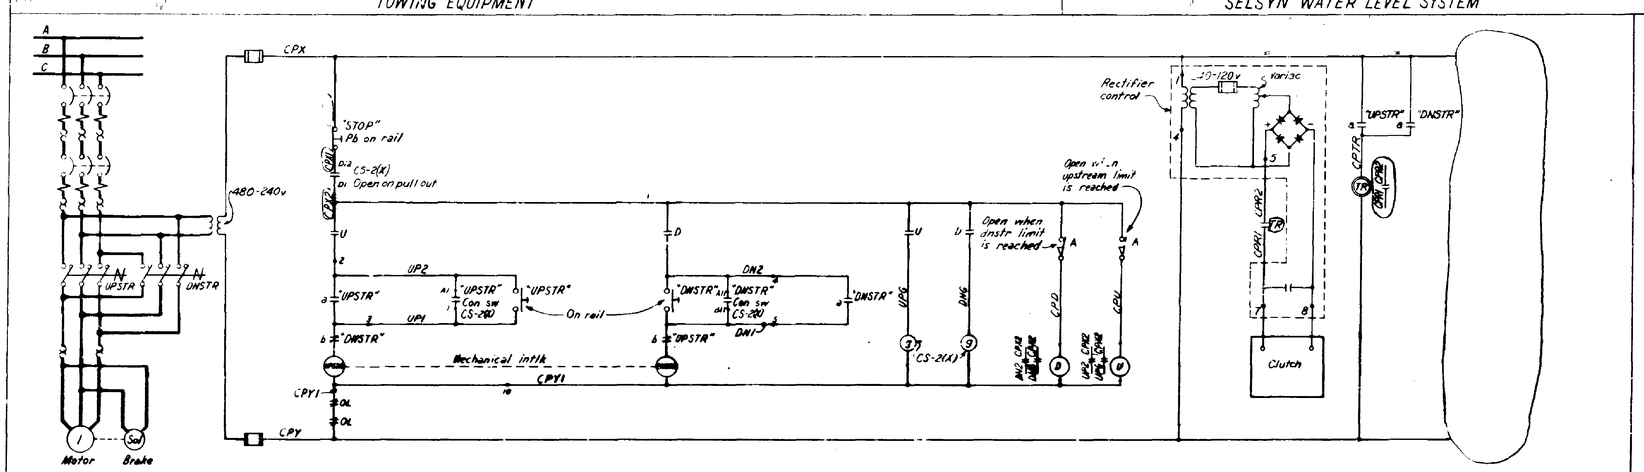

TRAVELING CHECK POST

NOTES:
1. Towing equipment resistors values are as follows:
R1-R2 = 11.4 ohms
R2-R3 = .72 ohms
R3-R4 = .48 ohms
R4-R5 = .20 ohms
R5-R6 = .20 ohms

AUXILIARY LOCK

WIRING DIAGRAMS
480V A-C POWER
SCHEMATIC DIAGRAMS SH.-4

NICKAJACK PROJECT
TENNESSEE VALLEY AUTHORITY
DIVISION OF DESIGN

SUBMITTED	RECOMMENDED	APPROVED

KNOXVILLE	3-6-67	69	E	4	65N1731 R1

RECORD DRAWING AS CONSTRUCTED