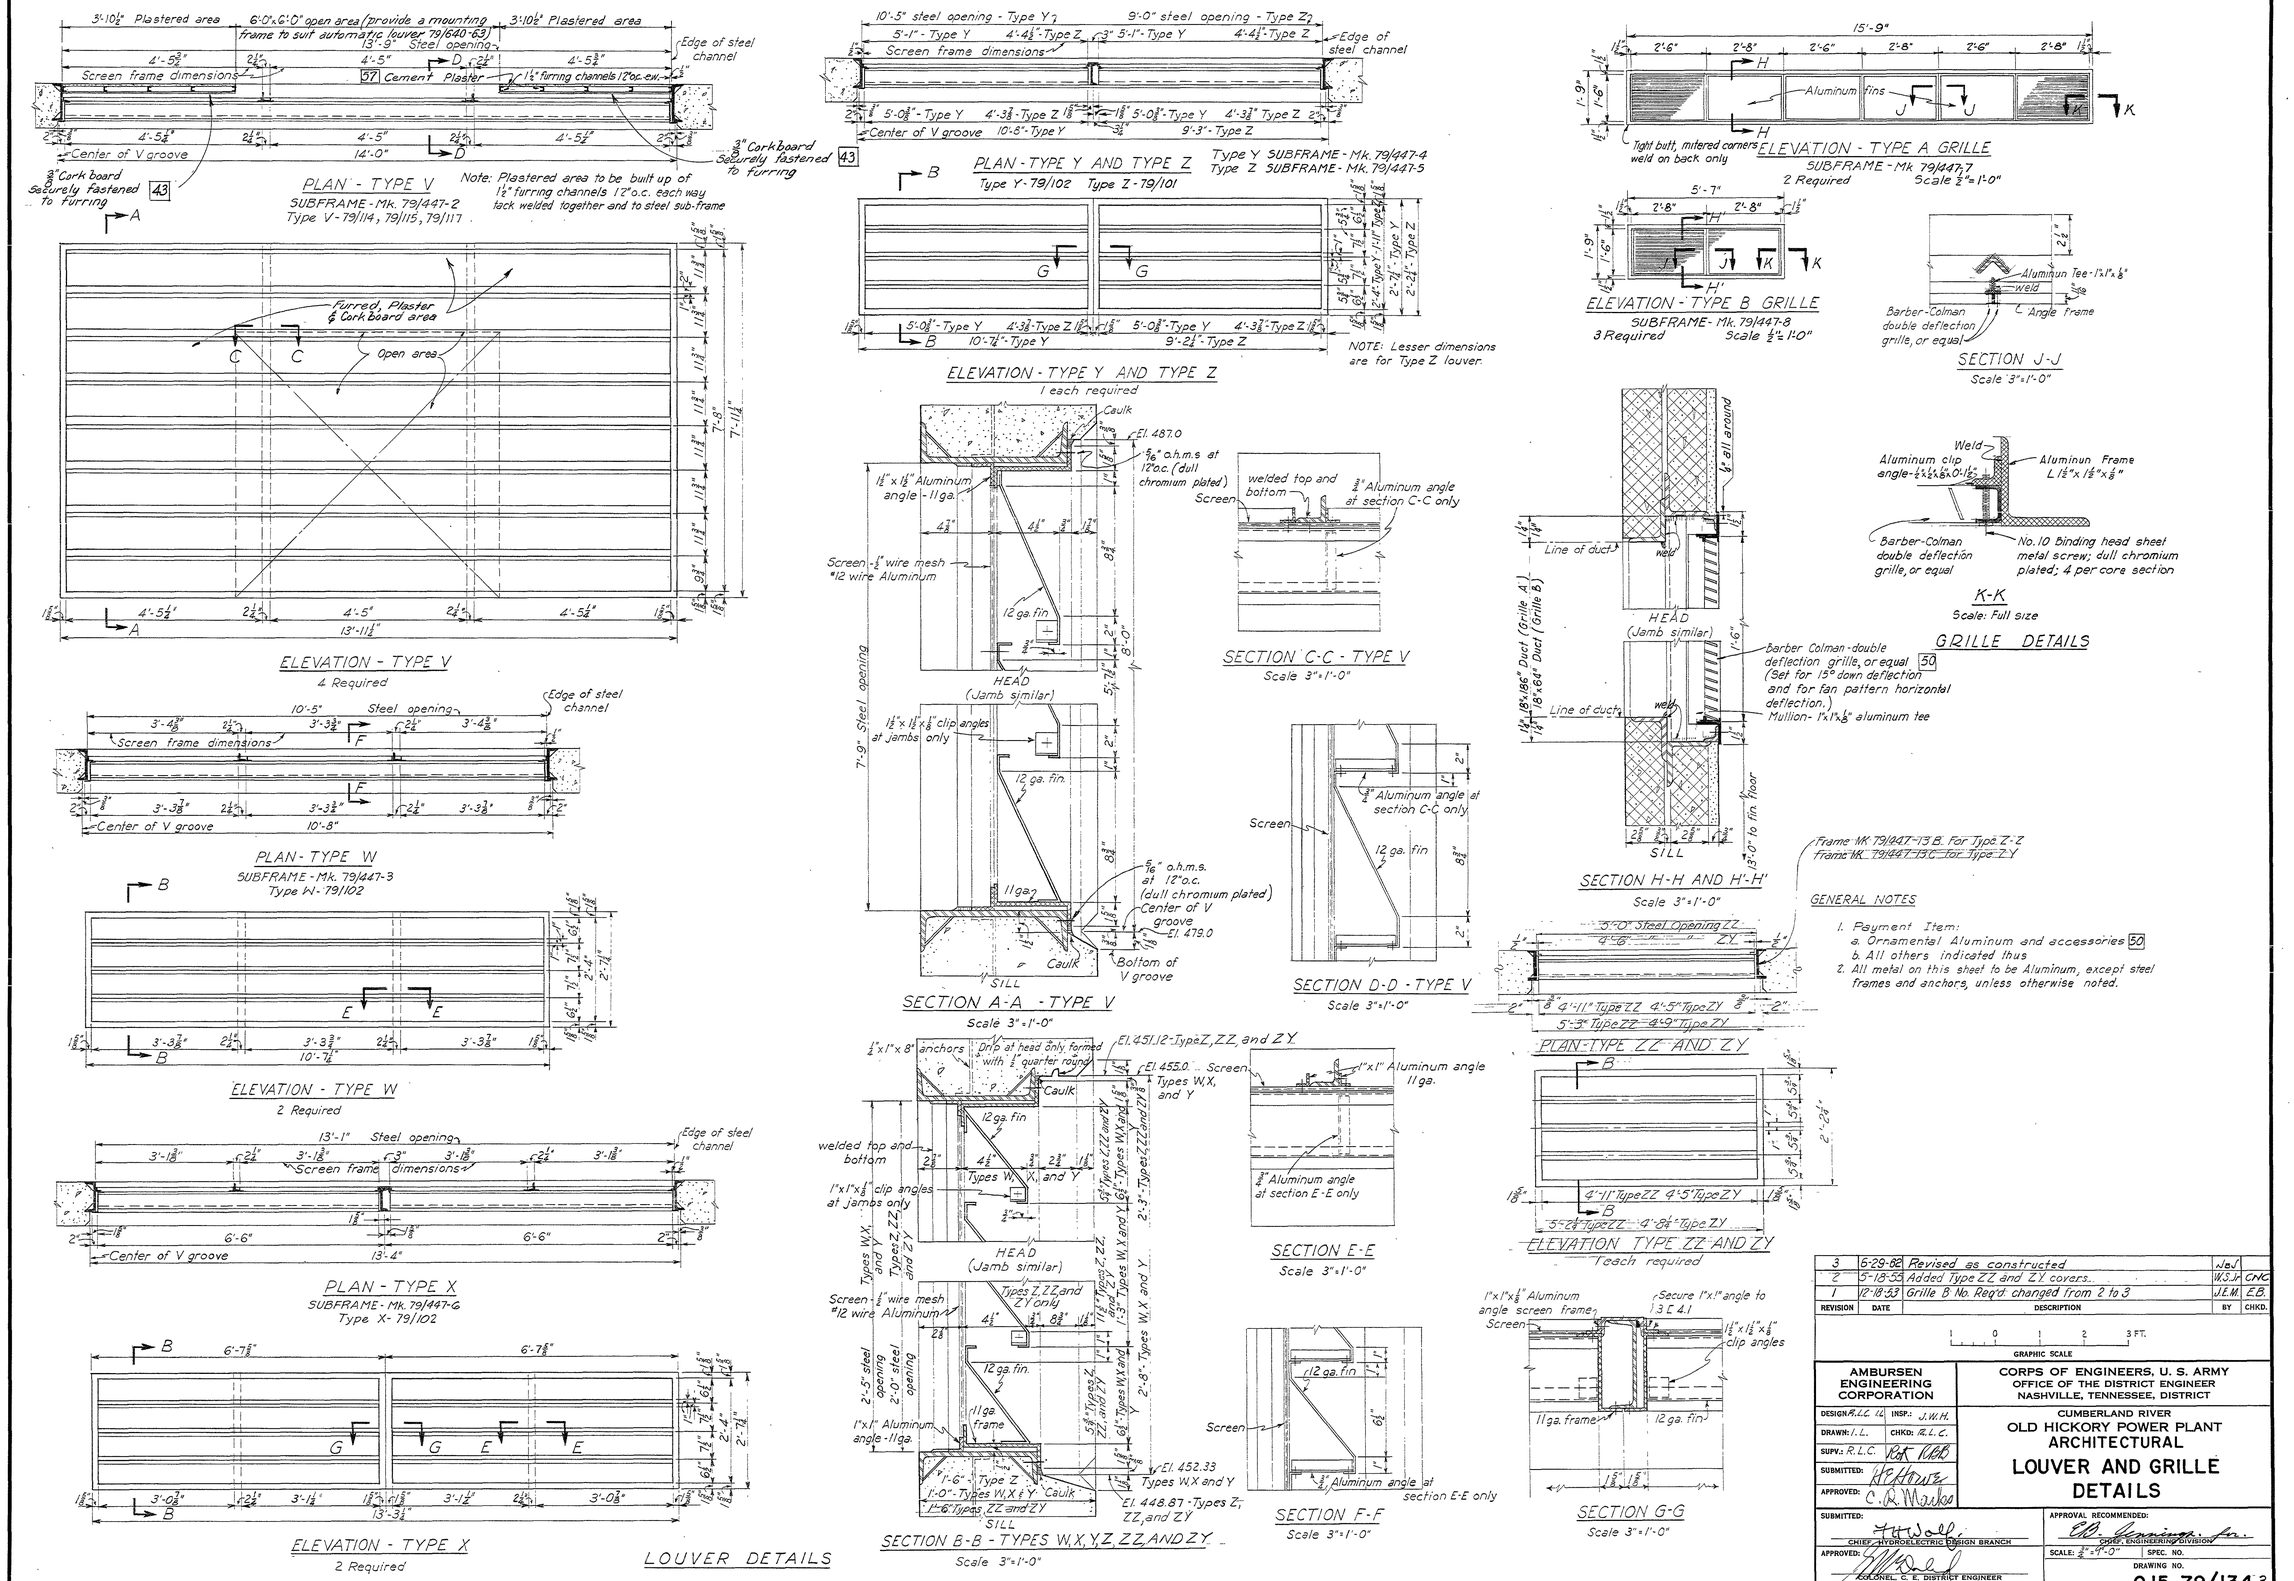

GENERAL NOTES

1. Payment Item:
   a. Ornamental Aluminum and accessories 50
   b. All others indicated thus
2. All metal on this sheet to be Aluminum, except steel frames and anchors, unless otherwise noted.

REVISION	DATE	DESCRIPTION	BY	CHKD.
3	6-29-62	Revised as constructed	JeJ	
2	5-18-55	Added Type ZZ and ZY covers.	W.S.Jr	CNC
1	12-18-53	Grille B No. Req'd. changed from 2 to 3	J.E.M.	E.B.

GRAPHIC SCALE 1 0 1 2 3 FT.

AMBURSEN ENGINEERING CORPORATION

CORPS OF ENGINEERS, U. S. ARMY
OFFICE OF THE DISTRICT ENGINEER
NASHVILLE, TENNESSEE, DISTRICT

CUMBERLAND RIVER
OLD HICKORY POWER PLANT
ARCHITECTURAL

LOUVER AND GRILLE DETAILS

DESIGN: R.L.C. LL INSP.: J.W.H.
DRAWN: I.L. CHKD: R.L.C.
SUPV.: R.L.C. Rob RBB
SUBMITTED: H.E. Howe
APPROVED: C.R. Marks
SUBMITTED: F.H. Wolf, CHIEF, HYDROELECTRIC DESIGN BRANCH
APPROVED: COLONEL, C. E. DISTRICT ENGINEER
DATE: JAN. 1953
APPROVAL RECOMMENDED: E.B. Jennings, Jr. CHIEF, ENGINEERING DIVISION
SCALE: ¾" = 1'-0" SPEC. NO.
DRAWING NO. Q15-79/134.3
SHEET OF

RECORD DRAWING AS CONSTRUCTED